


Tie Sheet


80 West 50 South,
Willard, Utah 84340

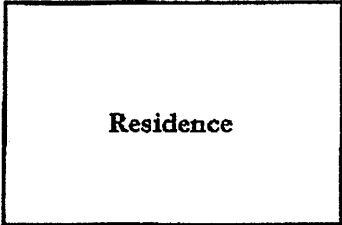

Contractor: _____ Address: _____ Ph. # _____

* Homeowner is responsible for sewer service between home and sewer main.

Date Completed _____
Site Address: _____
Pipe Size _____
Depth of pipe at P/L _____
Depth of pipe at building _____
Length From Main to Building _____
Number of Cleanouts _____
Groundwater Yes No - If yes what depth? _____
Comments: _____

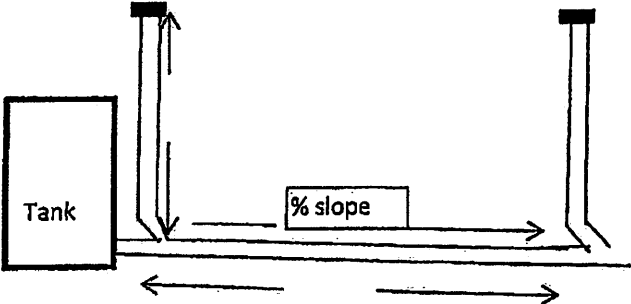

Willard City

80 West 50 South,
Willard, Utah 84340

Tie Sheet Close-out Process

Request an appointment for a site visit/connection verification at 435-734-9881. Allow 24-48 hrs. Inspections will be done Monday-Friday from 7:00 a.m.-3:00 p.m. Complete 2 copies of the form (front and back) prior to inspector's arrival.

Tie Sheet diagram (on back) includes the following:

- North Arrow
 - Label Streets
 - Service pipe size, depth, and slope
 - Clean outs (with ties)
 - Identify bends
 - Hook-up to main verification
- Contractor name _____, Phone # _____

I hereby declare under penalty of perjury that this application form and all information submitted as part of this application is true, complete and accurate to the best of my knowledge. Should any information or representation submitted in connection with this application form be incorrect or untrue, I understand that Willard City may rescind any approval or sufficiency determination, or take other appropriate action.

Sewer Lateral Installer/Contractor

Date

Resident/Homeowner

Date

For Office Use Only:

I have visited the site and verified the location and conditions at the sewer lateral connection.

Sewer Connection Reviewer

Date

City Copy

Homeowner Copy